


PLAN VIEW
1/8" = 1' 0"

AREA OF WORK

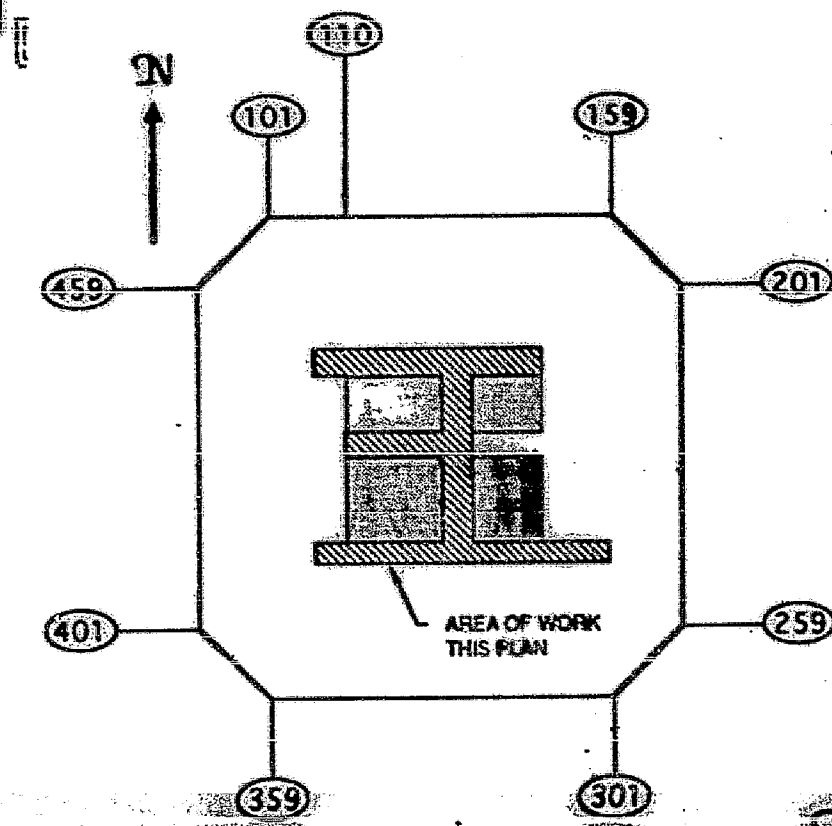

KEY PLAN #1-WTC-105
NOT TO SCALE

SIGNED *[Signature]*
ILYA ASANOVICH/NTX INTERIORS
GENERAL CONTRACTOR
CERTIFIED "AS BUILT" DRAWING

2	CERTIFIED AS-BUILT, RESUBMIT FOR RECORD	4/26/94
1	REVISED AS PER PORT AUTHORITY COMMENTS	11/2/94
REV. NO.	DESCRIPTION	DATE
Gantor Fitzgerald Securities One World Trade Center Floor 105 New York, NY 10048 TAA 941154		
ELECTRICAL LIGHTING PLAN - CORRIDOR		
John C. Westrick & Associates CONSULTING ENGINEERS 2110 Maple Avenue South Plainfield, NJ 07080 (908) 561-4170 Fax (908) 561-9399		
SCALE AS SHOWN	DWN BY: BB	CHKD BY: JCW
DATE: 9/22/94	JOB NO: 941154	



105
CORRIDOR
F-3

THA # 941154
11/8/94